
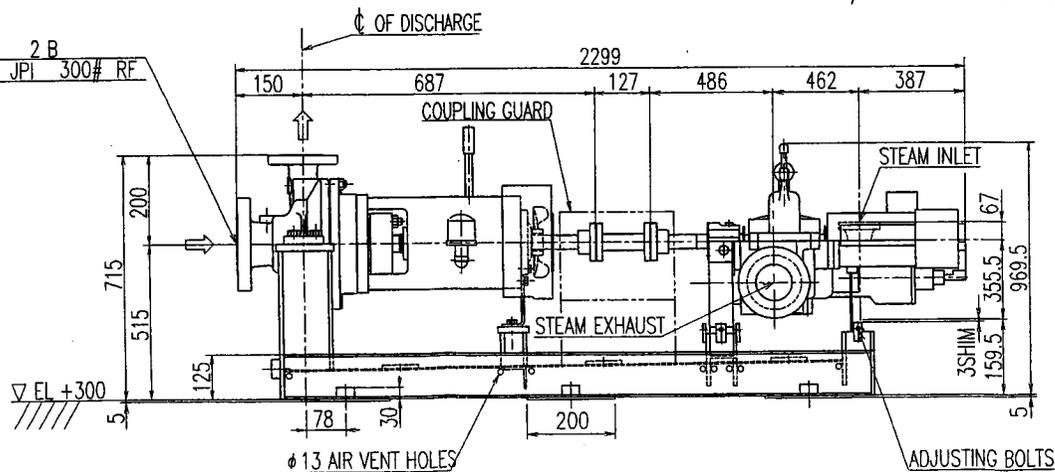
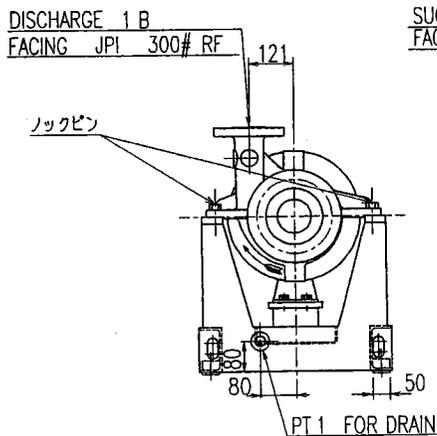
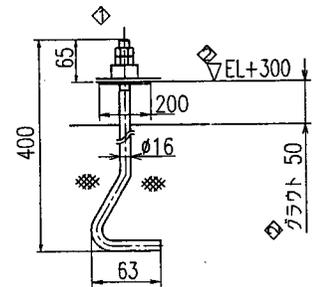
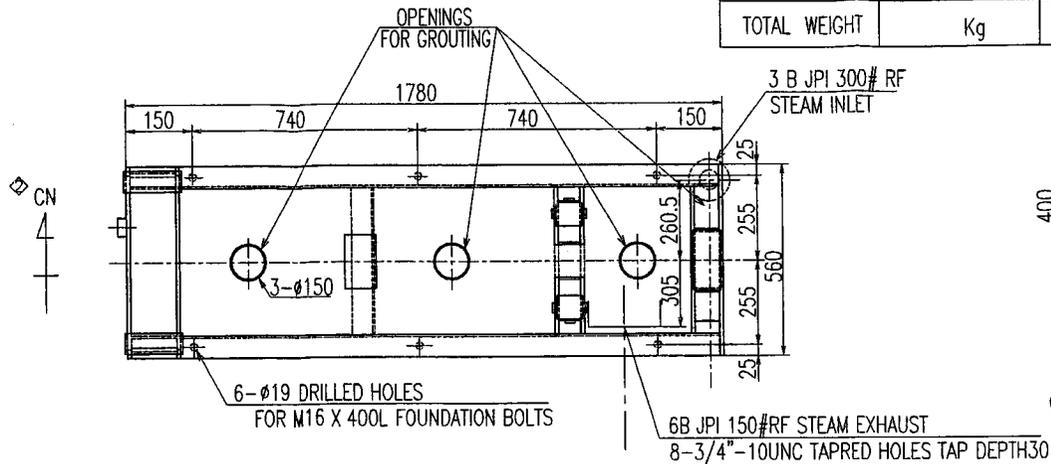


	Fx	Fy	Fz	Mx	My	Mz
SUCTION	182	118	145	94	72	47
DISCHARGE	145	182	118	94	72	47

F=Kg, M=Kg.m

2218

PUMP DATA		TURBINE DATA	
PUMP WEIGHT	Kg	TYPE	
BASE WEIGHT	Kg	OUT PUT	Kw
		SPEED	rpm
TOTAL WEIGHT	Kg	WEIGHT	Kg

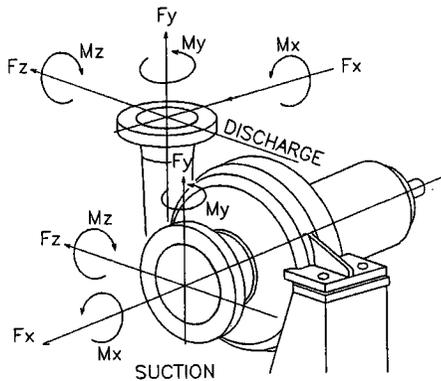

完成図書

SERVICE	移送ポンプ		
ITEM No.	: P-		
VOLUTE PUMP OUTLINE ELEVATION			
ORDER No. A11H081	DATE	SCALE N.T.S	
DRAWN	CHECKED	APPROVED	

REV	DATE	BY	CHECKED	APPROVED	NOTE
◇					
◇					
◇					

INQ No.

E0423734 1-1/2-71